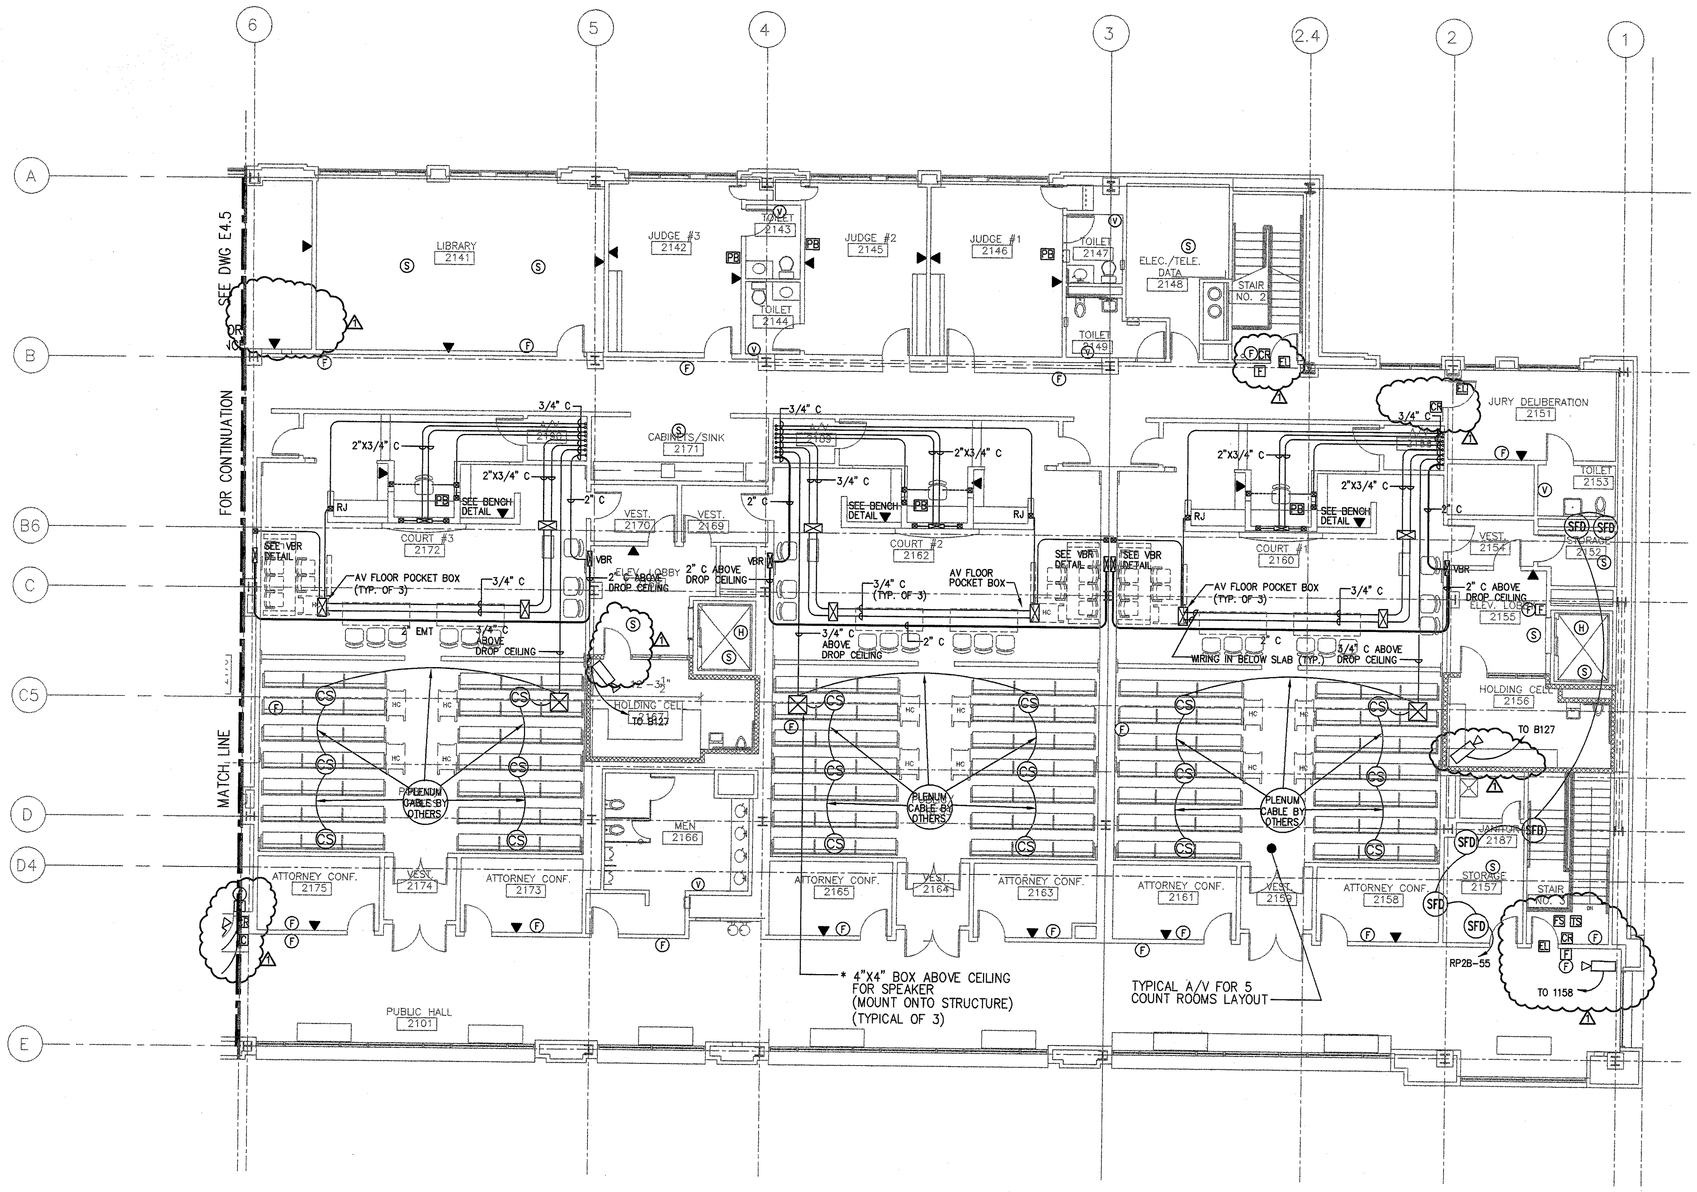

NOTES

1. ALL CARD READER LOCATIONS SHALL HAVE CARD READER, REX (REQUEST FOR EXIT/ MOTION DETECTOR) DOOR CONTACTS AND ELECTRIC STRIKE.
2. CONTRACTOR SHALL COORDINATE EXACT NUMBER, AND OPERATION/ CONTROL LOCATION OF ALL THE DEVICES WITH OWNER PRIOR TO INSTALLATION AND SHALL SUBMIT ALL SHOP DWGS. FOR APPROVAL.
3. CONTRACTOR SHALL PROVIDE GLASS BREAK SENSOR ON ALL EXTERIOR GLASS OF THE BUILDING PERIMETER AT GROUND LEVEL.
4. ALL EMPTY 1" CONDUITS FOR ~~INTERCOM AND CCTV CAMERAS~~ SHALL TERMINATE IN SECURITY ROOM 1158, EXCEPT HOLDING CELLS. 1
5. FOR FINISH OF FIXTURES, COVER ~~PLATES, SWITCHES, FIXTURE~~ TRIM, REFER TO ARCHITECTURAL DRAWINGS.
6. FOR GENERAL NOTES, SYMBOL LIST, AND ABBRAVIATIONS REFER TO DRAWING E1.1.
7. FOR PANEL SCHEDULES REFER TO DRAWINGS E6.1 – E6.3.
8. LOCATIONS OF ALL DUCT SMOKE DETECTIONS SHALL BE COORDINATED WITH MECHANICAL DUCT LAYOUT.
9. FOR FIRE ALARM RISER DIAGRAM REFER TO DRAWING E5.3.
10. FOR FAAP AND GRAPHIC ANNUNCIATOR PANEL REFER TO DRAWING E5.4
11. THE GENERAL CONTRACTOR IS REQUIRED TO COORDINATE THE WORK WITH OWNER'S EQUIPMENT VENDORS FOR ALL N.I.C. WORK.
12. FOR DETAIL OF JUDGE'S BENCH SEE DWG. E 4.8

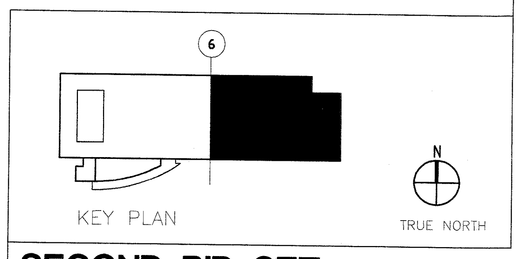

0' 2' 4' 8' 16' 24'

SECOND BID SET

Revisions: No.	Date:	
1	11/01/01	CHANGE BULLETIN 36

RCG ▫ HOK
Joint Venture

Architects
Richter Cornbrooks Gribble Inc.
231 East Baltimore St. 12th Flr
Baltimore, Maryland 21202
(410) 685-7033

Architects
Hellmuth Obata & Kassabaum, PC
Canal House, 3223 Grace Street, N.W.
Washington, D.C. 20007
(202) 339-8700

Restl Designers, Inc.
Structural Engineers
9055 Gaither Road
Suite E
Gaithersburg, MD 21201
(301) 258-0933

John J. Christie & Associates
Mech / Elect Engineers
5028 Wisconsin Ave
Suite 200
Washington D.C. 20016
(202) 364-4410

A. Morton Thomas & Associates
Civil Engineers
12750 Twinbrook Parkway
Suite 200
Rockville, MD 20852
(301) 881-2545

SEAL :

USING AGENCY APPROVAL
TITLE DATE

DEPARTMENT OF GENERAL SERVICES APPROVAL
PROJECT ADMINISTRATOR DATE
DIRECTOR, ENGR. & CONSTR. DATE

DRAWING TITLE:
PARTIAL SECOND FLOOR AUXILLIARY SYSTEMS PLAN

SOUTH BALTIMORE DISTRICT COURT

PATAPSCO AVE AND 7TH ST BALTIMORE, MARYLAND

PROJECT NO. BC-000-861-001
DATE : 10-31-01
DRAWING NO. E4.4
SHEET ___ OF ___

C:\Documents and Settings\todd.RCG.COM\Desktop\5911_CD\Bcc-e44.dwg Fri Nov 02 15:14:05 2001 Jack